

THIS DRAWING IS UNPUBLISHED. RELEASED FOR PUBLICATION -,- .
© COPYRIGHT – By Tyco Electronics Japan G.K. ALL RIGHTS RESERVED.


LOC	DIST
—	—

REVISIONS

P	LTR	DESCRIPTION	DATE	DWN	APVD
	F	REVISED	27SEP2013	H.U	N.Y

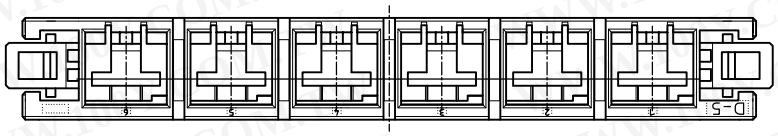


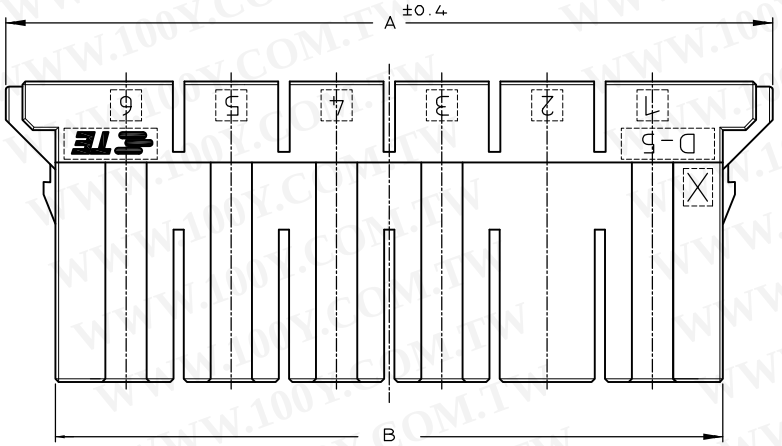

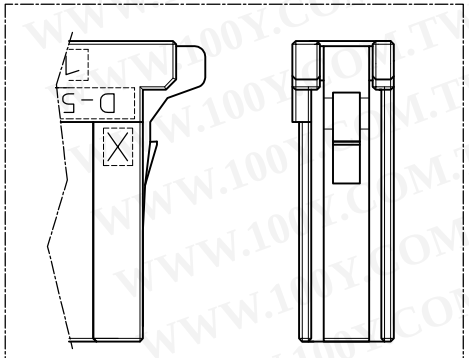


2P,3P ONLY


AS SHOWN
1-179958-6
(KEYING CODE:X)

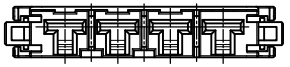


1-179958-4
(KEYING CODE:X)

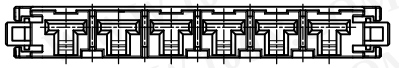

2-179958-6
(KEYING CODE:Y)

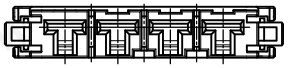

2-179958-4
(KEYING CODE:Y)

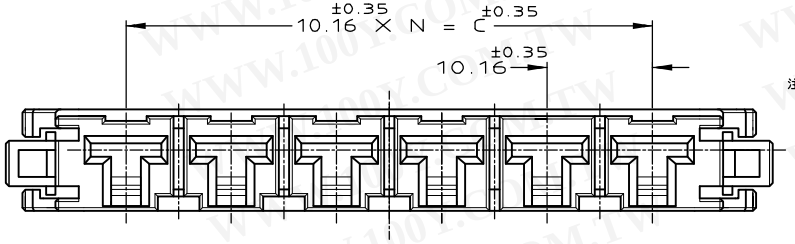


1-179958-6
(KEYING CODE:X)


注記
1. 材料：ハウジング：ガラス入り熱可塑性
ポリエステル樹脂（94V-0），色：黒
2. ~~ハウジング全面にテフロン塗装のこと~~
3. 製品規格 ：108-5453

NOTES
1. MATERIAL:HOUSING:GLASS FILED THERMO PLASTIC
,POLYESTER(94V-0),COLOR:BLACK
2. ~~TO COAT ALL SURFACE OF HOUSING WITH TEFLON~~
3. PRODUCT SPEC :108-5453


							BLACK	2-179958-6
	50.8	64.4	74	5	6	BLACK	1-179958-6
OBSOLETE 2								~~5-179958-4~~
						BLACK	2-179958-4
	30.48	44.08	53.68	3	4	BLACK	1-179958-4
OBSOLETE 2								~~5-179958-3~~
						NATURAL	9-179958-3
						BLACK	2-179958-3
	20.32	33.92	45.92	2	3	BLACK	1-179958-3
						BLACK	2-179958-2
	10.16	23.76	35.76	1	2	BLACK	1-179958-2
FINISH	C	B	A	N	POS	COLOR	P/N

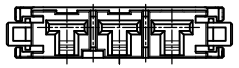


1-179958-3
(KEYING CODE:X)

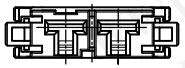

1-179958-2
(KEYING CODE:X)

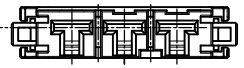

9-179958-3
2-179958-3
(KEYING CODE:Y)

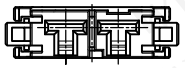

2-179958-2
(KEYING CODE:Y)

勝 特 力 材 料 886-3-5753170
胜特力电子(上海) 86-21-34970699
胜特力电子(深圳) 86-755-83298787
Http://www.100y.com.tw

THIS DRAWING IS A CONTROLLED DOCUMENT.

DIMENSIONS: mm

TOLERANCES UNLESS OTHERWISE SPECIFIED:
0 PLC ±
1 PLC ± 10≧ :±0.2
2 PLC ± 30≧ >10:±0.25
3 PLC ± 100≧ >30:±0.3
4 PLC ±
ANGLES ±3'

MATERIAL 4

FINISH

DWN	Y.ISHIKAWA	22MAR1995
CHK	S.MANABE	23MAR1995
APVD	S.MABABE	23MAR1995
PRODUCT SPEC		
APPLICATION SPEC		
WEIGHT		

CUSTOMER DRAWING

TE Connectivity

NAME
SINGLE ROW REC HSG
DYNAMIC D-5200
—

SIZE	CAGE CODE	DRAWING NO	RESTRICTED TO
A3	00779	C-179958	—

SCALE	SHEET	REV
2:1	1 OF 1	F

1470-19 (3/11)